


LEGEND: N.T.S.

SUBJECT PROPERTY LINES	---
TREE	
PROPERTY LINES	---
CALCULATED POINT	●
EXISTING ELEVATION (IN METRIC)	+17.57
UTILITY POLE	● UP
DRAINAGE FLOW DIRECTION	→
FINISH FLOOR	FF=
DESIGN ELEVATION	+32.3
FIRE HYDRANT	
SANITARY MANHOLE	
CURB STOP	
INVERTS	+23.60
EDGE OF TREES	
NEW GATE VALVE	
EXISTING GATE VALVE	
NEW WATER MAIN	---
EXISTING WATER MAIN	---
NEW SEWER MAIN	---
EXISTING SEWER MAIN	---
LIGHT POLE	● LP
FENCE POST	○ FP
UNDERGROUND ELECTRICAL	---
DOWN SPOUTS	DS
WOODEN PRIVACY FENCE LINE	x-x

- NOTES**
1. PLAN PREPARED IN METRIC, UNLESS (NOTED).
 2. PROPERTY REGISTRY INFORMATION OBTAINED FROM THE GEOMATICS INFORMATION CENTRE, TAXATION AND PROPERTY RECORDS, PROVINCE OF PEI.
 3. ELEVATIONS SHOWN IN METRIC REFERENCED TO HARVEST HILLS RECORD DRAWINGS.
 4. CONTOUR INTERVAL 0.25m.
 5. BUILDING ROOF DRAINAGE TO BE PIPED TO THE NEAREST DRAINAGE SWALE OR STREET DITCH. ALL DOWNSPOUTS ON WEST BUILDING ARE TIED INTO STORM SYSTEM, OR DIRECTED MERCEDES DRIVE DITCH.
 6. AS-BUILT DATA LOCATED ON JUNE 26, NOVEMBER 23 & 25, 30, 2020.

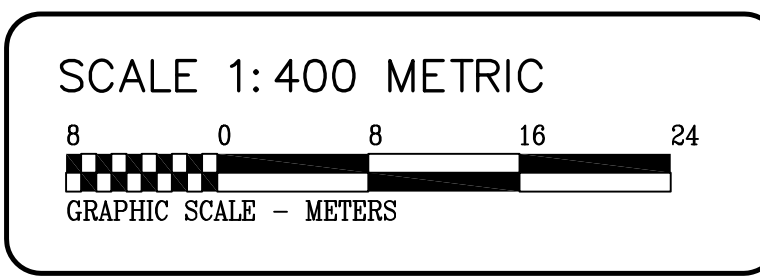

Prepared by:
Derek A. French
 Professional Services Inc.
 t: 902-394-2945
 dfrenchservices@gmail.com

Project Title

Lot 40 Mercedes Drive Harvest Hills

Plan Title

As-built Site Plan

Date Printed: Nov. 30, 2020	Drawn by: JWL
Job No. 20257	Plan No. D1